

501 Great Circle Road
Suite 150
Nashville, Tennessee 37228
Tel: (615) 255-2288
Fax: (615) 256-8332
www.brownandcaldwell.com

2005 MAY 13 A 11:06

May 10, 2005

27-126467.001

BROWN AND
CALDWELL

Mr. Anthony Lobred
USACE, Vicksburg District
Attn: Regulatory Branch
4155 Clay Street
Vicksburg, MS 39183-3435

RE: Groundwater Interim Measures
Certification of Compliance for Site ID#: 200209020
Grenada Manufacturing Site, Grenada, Mississippi

Dear Mr. Lobred:

Enclosed are the certification of compliance and the as-built drawing (Figure 1) for the areas actually filled at the above-referenced Site. Please note that the wetlands areas disturbed during the construction activities were actually less than originally proposed in Figure 2 (also enclosed) of the NW38 permit issued by the USACE on August 27, 2003.

Should you have any questions or need additional information, please do not hesitate to contact me at 615-250-1221. Thank you for your assistance with this project.

Sincerely,

BROWN AND CALDWELL



Michael J. Freehling, P.E., P.G.
Project Manager
Environmental Services

cc: Don Webster, USEPA Region 4
John Bozick, ArvinMeritor
Don Williams, Grenada Mfg.
John Devic, Collins & Aikman
Jeff Karp, Swidler Berlin Shereff Friedman

Enclosures (3)

Docket Number 450414

Certification of Compliance
With Department of the Army Permit

Nationwide Permit Number: NW38
Identification Number: 200209020
Name of Permittee: ArvinMeritor, Incorporated
Issued Date: 08/27/2003
Evaluator name: Anthony R. Lobred
Expiration Date: 08/27/2005

Upon completion of the activity authorized by this permit, sign this certification and return it to the following address:

USACE, Vicksburg District
ATTN: Regulatory Branch
4155 Clay Street
Vicksburg, Mississippi 39183-3435

Please note that your permitted activity is subject to a compliance inspection by an Army Corps of Engineers representative. If you fail to comply with this permit, you are subject to permit modification, suspension, or revocation.

I hereby certify that the work authorized by the above-referenced permit has been completed in accordance with the terms and conditions of the said permit including any required mitigation.

Date work was completed:

3-31-05




Signature of Permittee

4-29-05

Date Signed

(ENC 4)

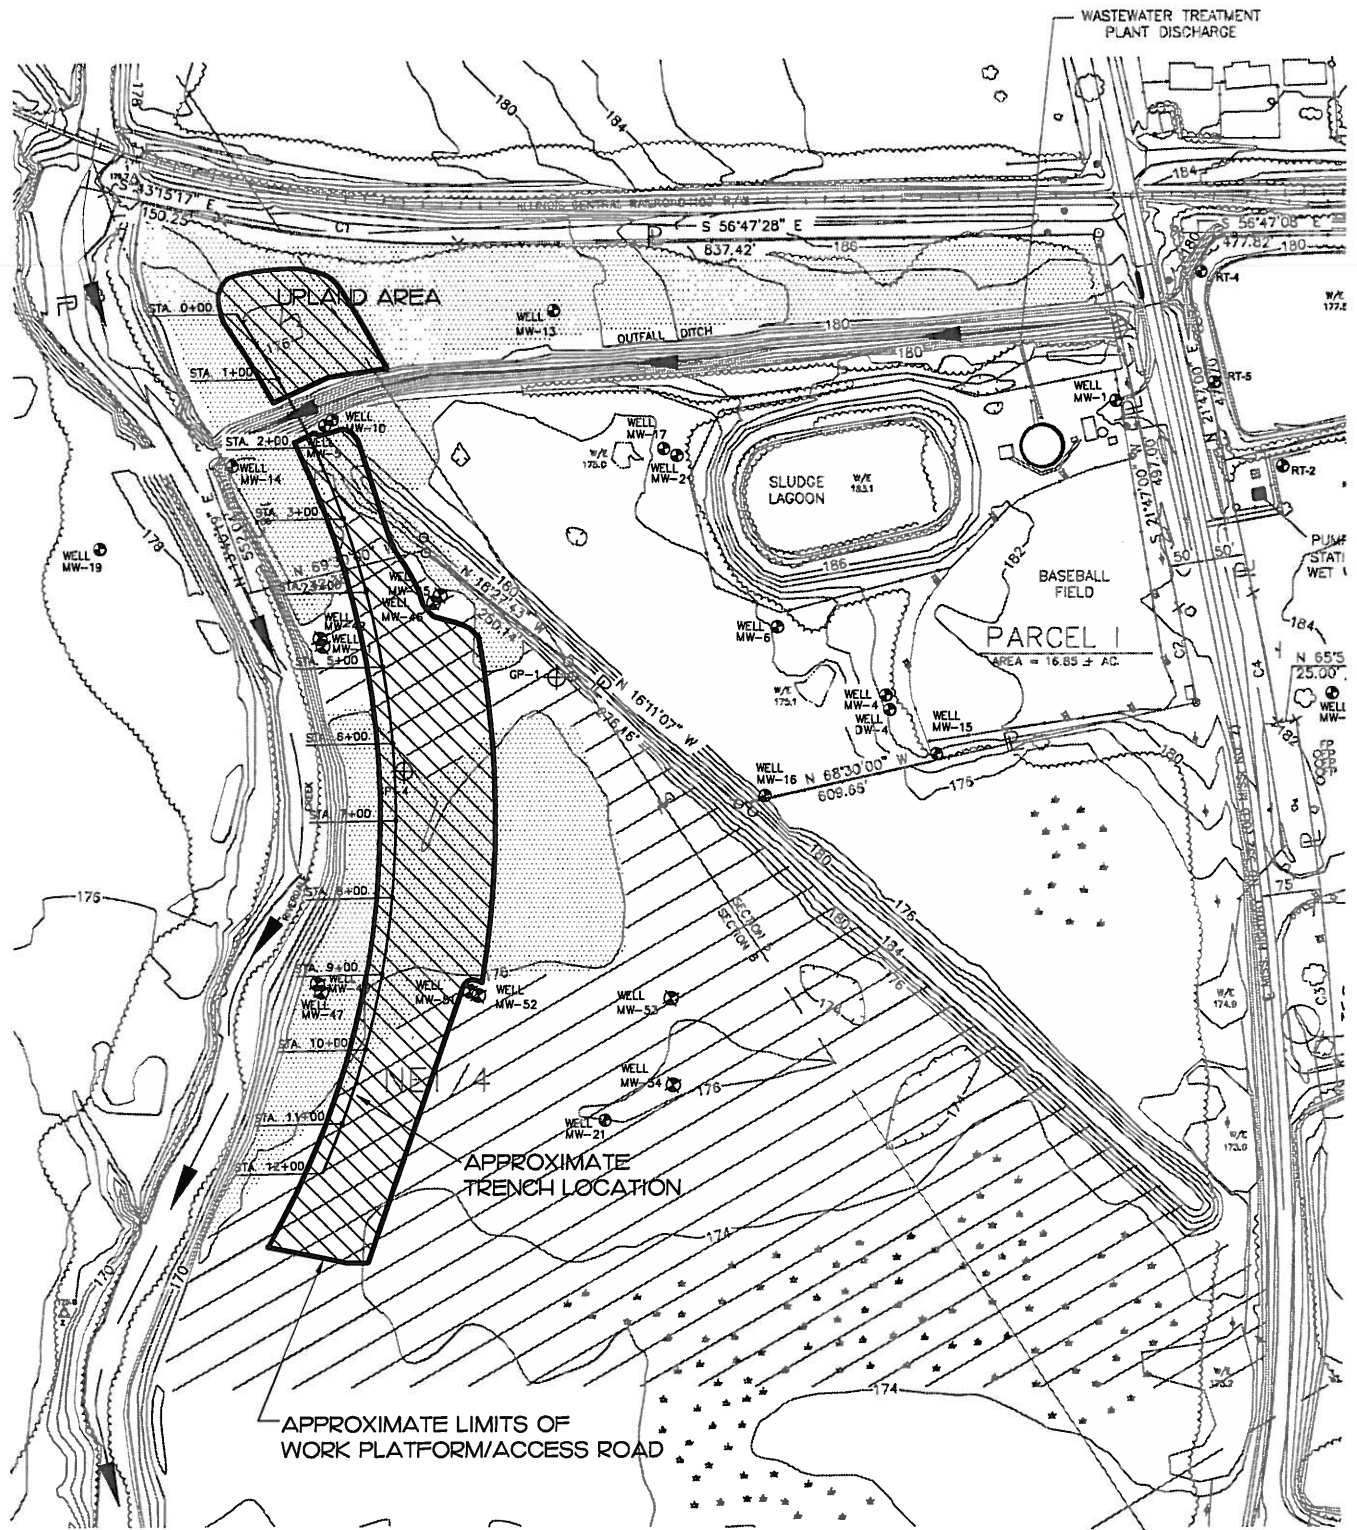

LEGEND

- Monitoring Well
- Geoprobe Piezometer
- Surface Water Flow Direction
- Wetlands Area
- Actual Fill Area
- Uplands Area



FIGURE 1

**AS-BUILT
AREAS ACTUALLY FILLED**

GRENADA MANUFACTURING, LLC PLANT
GRENADA, MISSISSIPPI

126467.001

05/05

**BROWN AND
CALDWELL**

Nashville, Tennessee

SOURCE: MAP PREPARED BY ALMON ASSOCIATES, 1993. WELL LOCATIONS SHOWN ARE APPROXIMATE.

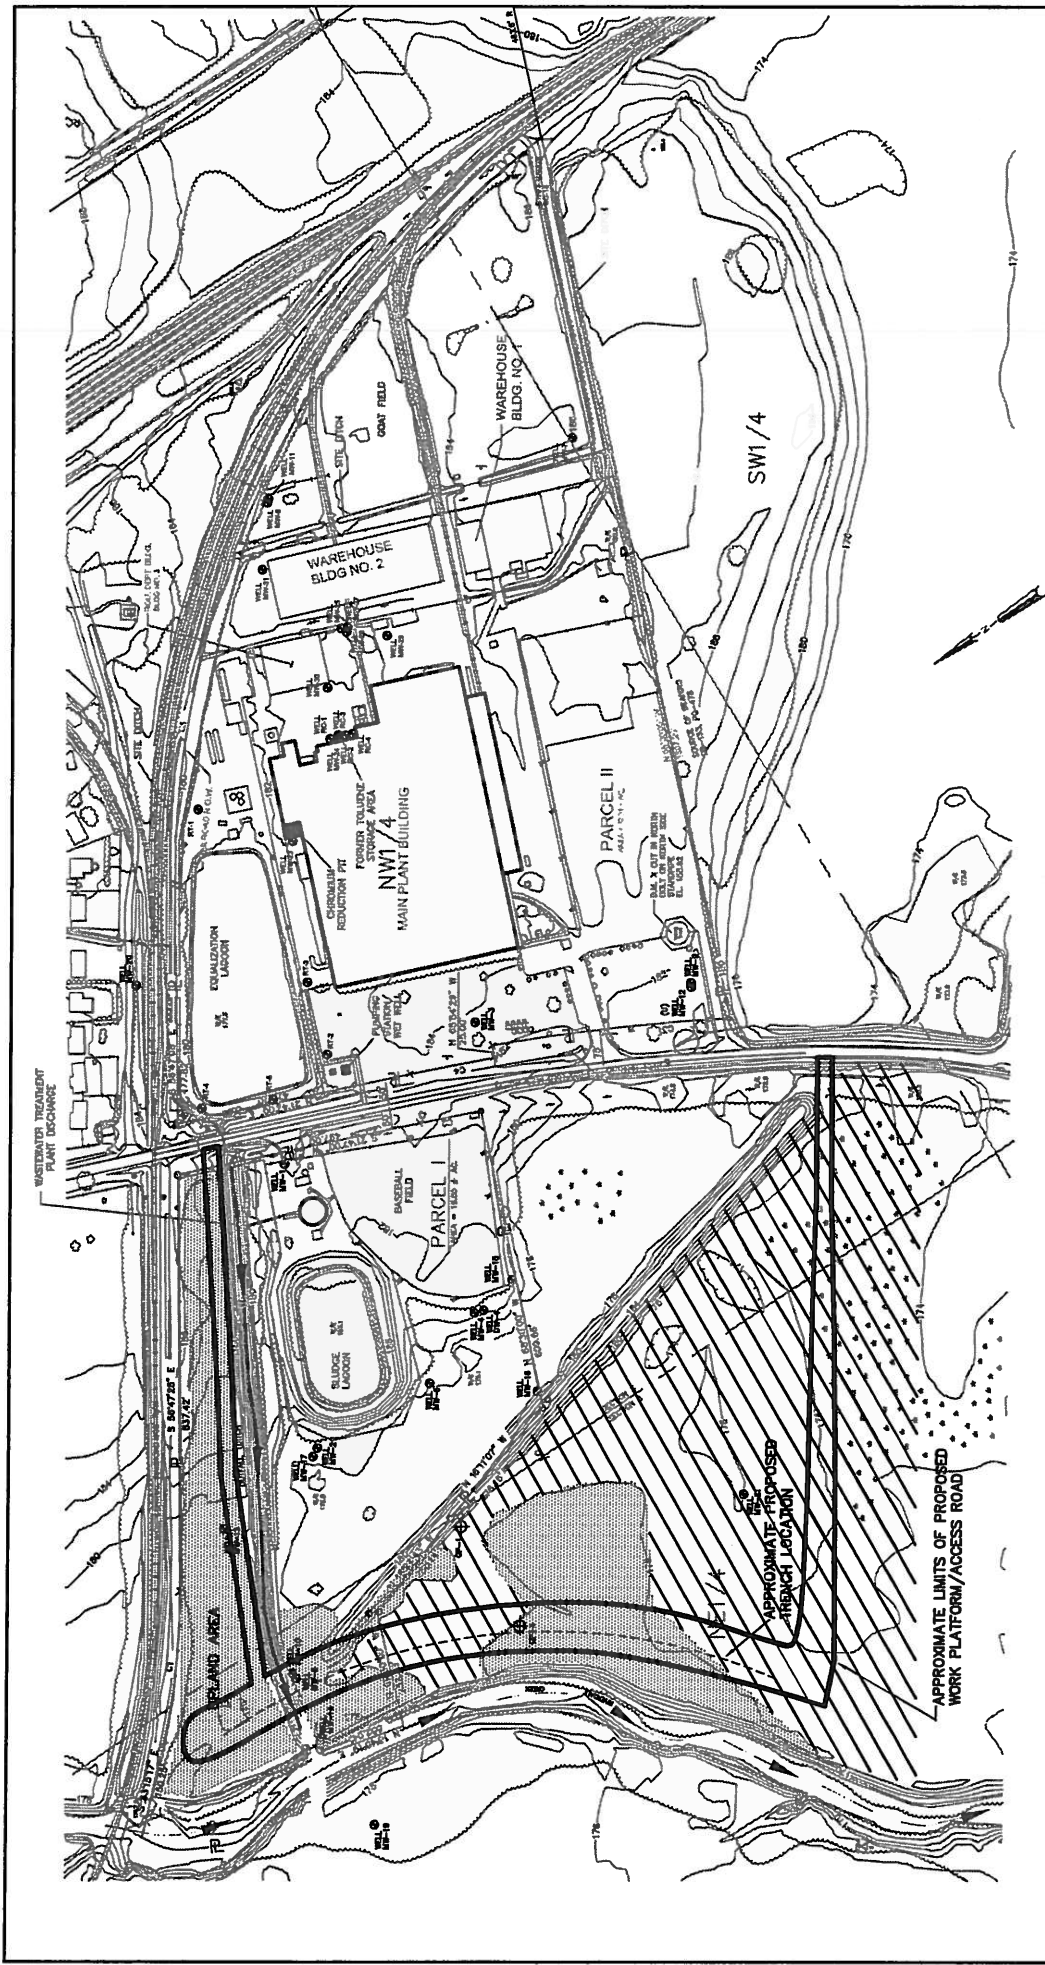



FIGURE 2

WETLANDS AREAS

GRENADA MANUFACTURING, LLC PLANT
GRENADA, MISSISSIPPI

19071.001 08/02

BROWN AND CALDWELL
Nashville, Tennessee

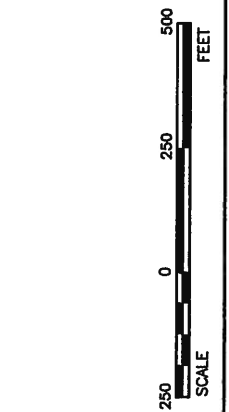

LEGEND

- Monitoring Well
- Geoprobe Piezometer
- Surface Water Flow Direction
- Wetlands Area
- Uplands Area

APPROXIMATE LIMITS OF PROPOSED WORK PLATFORM/ACCESS ROAD

APPROXIMATE PROPOSED TRENCH LOCATION

SOURCE: MAP PREPARED BY ALMON ASSOCIATES, 1993. WELL LOCATIONS SHOWN ARE APPROXIMATE.